


<u>WERI</u>	Client: Transport Canada		Remedial Work FTA and Land Treatment Unit Norman Wells Airport, Norman Wells, NT Plan View of LTU	
	Drawn By: AM	Scale: NTS	Units: Metres	Date: May 2004
			Figure No.: 1	

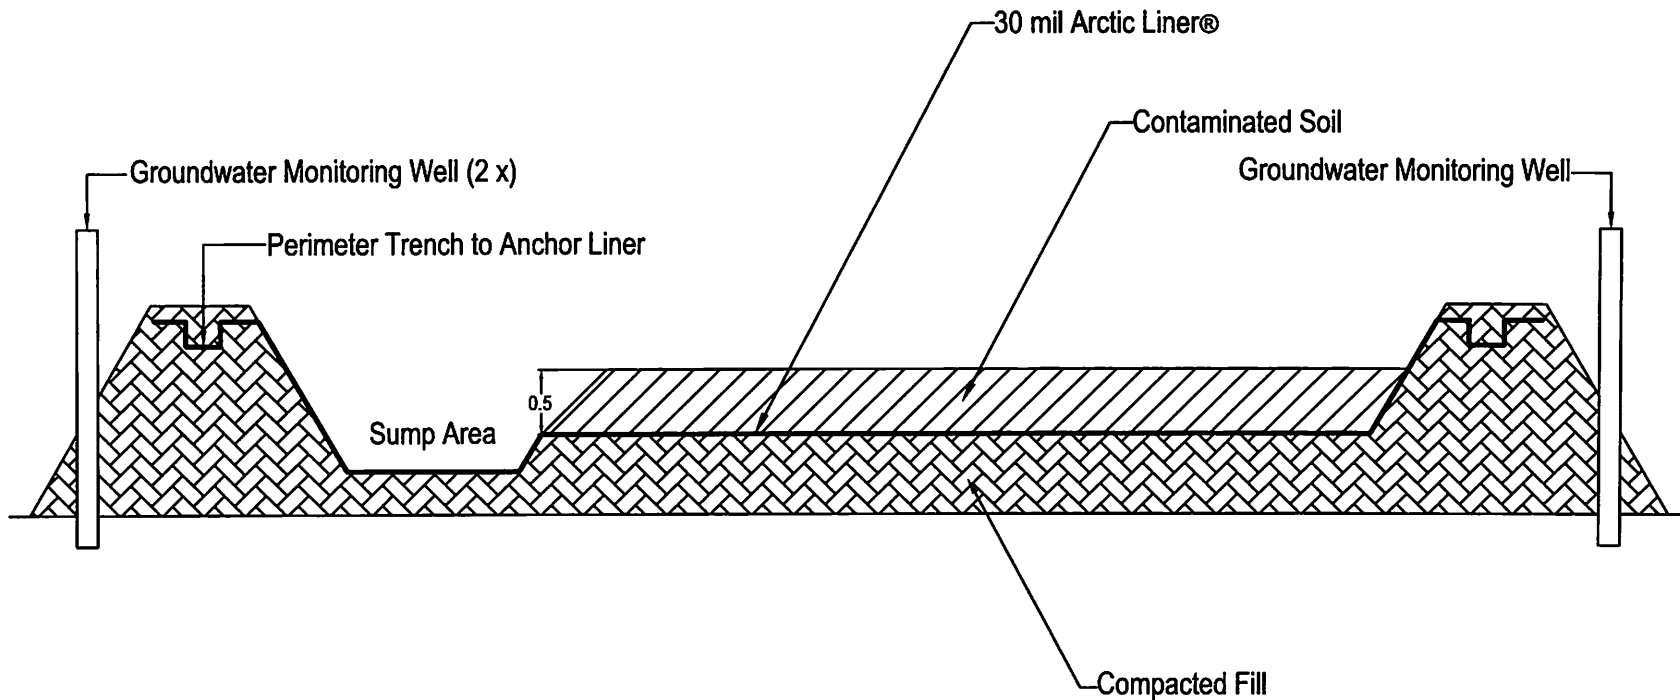

<u>WERI</u>	Client: Transport Canada		Remedial Work FTA and Land Treatment Unit Norman Wells Airport, Norman Wells, NT Cross-Section of LTU	
	Drawn By: AM	Scale: NTS	Units: Metres	Date: May 2004
			Figure No.: 2	