


**LEGEND**

- - - - - Battery #3 Area Extents
- POWER - Underground Powerline
- PIPE — HDPE Pipeline
- Electrical Service
- - - - - Access Road Extents
- X — Location of Chain Fence
- X — Location of Snow Fence

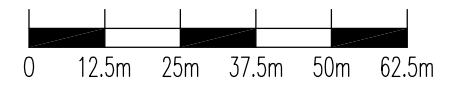

A	PRELIMINARY	2016-07-05	D.W.	S.A.	P.G.
NO.	VERSION	DATE	BY	VERIF.	APPR.

**Imperial Oil Limited**  
 NORMAN WELLS PRODUCTION COMPLEX, NORMAN WELLS, NT  
 SITE PLAN AS BUILT

Soils Materials Environment

**Englobe**

Englobe Corp.  
 16114 - 114 Avenue NW  
 Edmonton, Alberta, T6M 2Z5, Canada  
 Phone: 780-481-1416 Fax: 780-481-9008

MEASUREMENT UNIT: <b>METRE</b>	SCALE: <b>1:1,250</b>	DATE (month-year): <b>JULY 2016</b>
DRAWN BY: <b>D. WILSON</b>	VERIFIED BY: <b>S. ALIMOHAMED</b>	APPROVED BY: <b>P. GINGRAS</b>
PROJECT NO: ES5500_500_502	DRAWING NO: ES5500_500_502_POND_PAD_AS_BUILT	PAGE NAME: PL

**FIGURE 1**

G:\Projects\ES5500\500\502\ES5500\_500\_502\_POND\_PAD\_AS\_BUILT.dwg, PL, 2016-07-05 11:27:04 AM